

DEPARTMENT OF ENVIRONMENTAL MANAGEMENT  
 OFFICE OF WATER RESOURCES  
 FRESHWATER WETLANDS PERMIT  
 APPROVED WITH CONDITIONS  
 AS SPECIFIED IN THE LETTER OF APPROVAL  
 DATED NOV 08 2013 FILE # 13-0174  
 NO CHANGES ALLOWED WITHOUT PERMIT  
 APPROVED PLANS MUST BE AT CONSISTENT WITH

**Note:**

Existing fill in pond to be removed when water level is lowered in late fall. Silt fence to be installed on pond side of fill area prior to removal.

*DEM Note: The width of the dock shall be no greater than six (6) feet as shown on sheet 2 of 3.*

**Legend**

- 5 Ft Blueberry
- 5.5 Ft Red Oak

REVISION "B" BLOCKED

**As Built Restoration Site Plan**  
 Assessor's Plat 83/Block 10/Lot 8

**Located at East Shore Drive**  
**In the Town of Exeter, Rhode Island**

Prepared for: Richard Siciliano  
 7 Yankee Drive Westerly, R.I.  
 June 4, 2013  
**Coventry Survey Co., Inc.**

46 South Main Street  
 Coventry, Rhode Island 02816  
 Phone (401) 823-5028  
 Fax (401) 827-0203  
 Land Surveying / Mapping / O&MS Design

JOHN E. ROCKWELL  
 No. 1959  
 PROFESSIONAL LAND SURVEYOR  
 6/4/13

UTILITY POLE #24  
 PROPOSED NEW DOCK  
 ASSESSOR'S PLAT 83  
 BLOCK 10/LOT 8  
 SHEET 1 OF 3  
 PREPARED BY:  
 RICH SICILIANO - OCT 2013

REVISION "B"  
 THIS SURVEY AND PLAN CONFORM TO A CLASS III STANDARD AS ADOPTED BY THE RHODE ISLAND BOARD OF REGISTRATION FOR PROFESSIONAL LAND SURVEYORS.  
 BY: *John Johnson*  
 REGISTERED PROFESSIONAL LAND SURVEYOR






DEPARTMENT OF ENVIRONMENTAL MANAGEMENT  
 OFFICE OF WATER RESOURCES  
 FRESHWATER WETLANDS PROGRAM  
 APPROVED WITH CONDITIONS  
 AS SPECIFIED IN THE LETTER OF APPROVAL  
 DATED NOV 08 2013 FILE # 13-0174  
 NO CHANGES ALLOWED WITHOUT PRIOR APPROVAL  
 APPROVED PLANS MUST BE AT CONSTRUCTION SITE

*Martin D. Wenzel*

APPLICATION # 13-0174

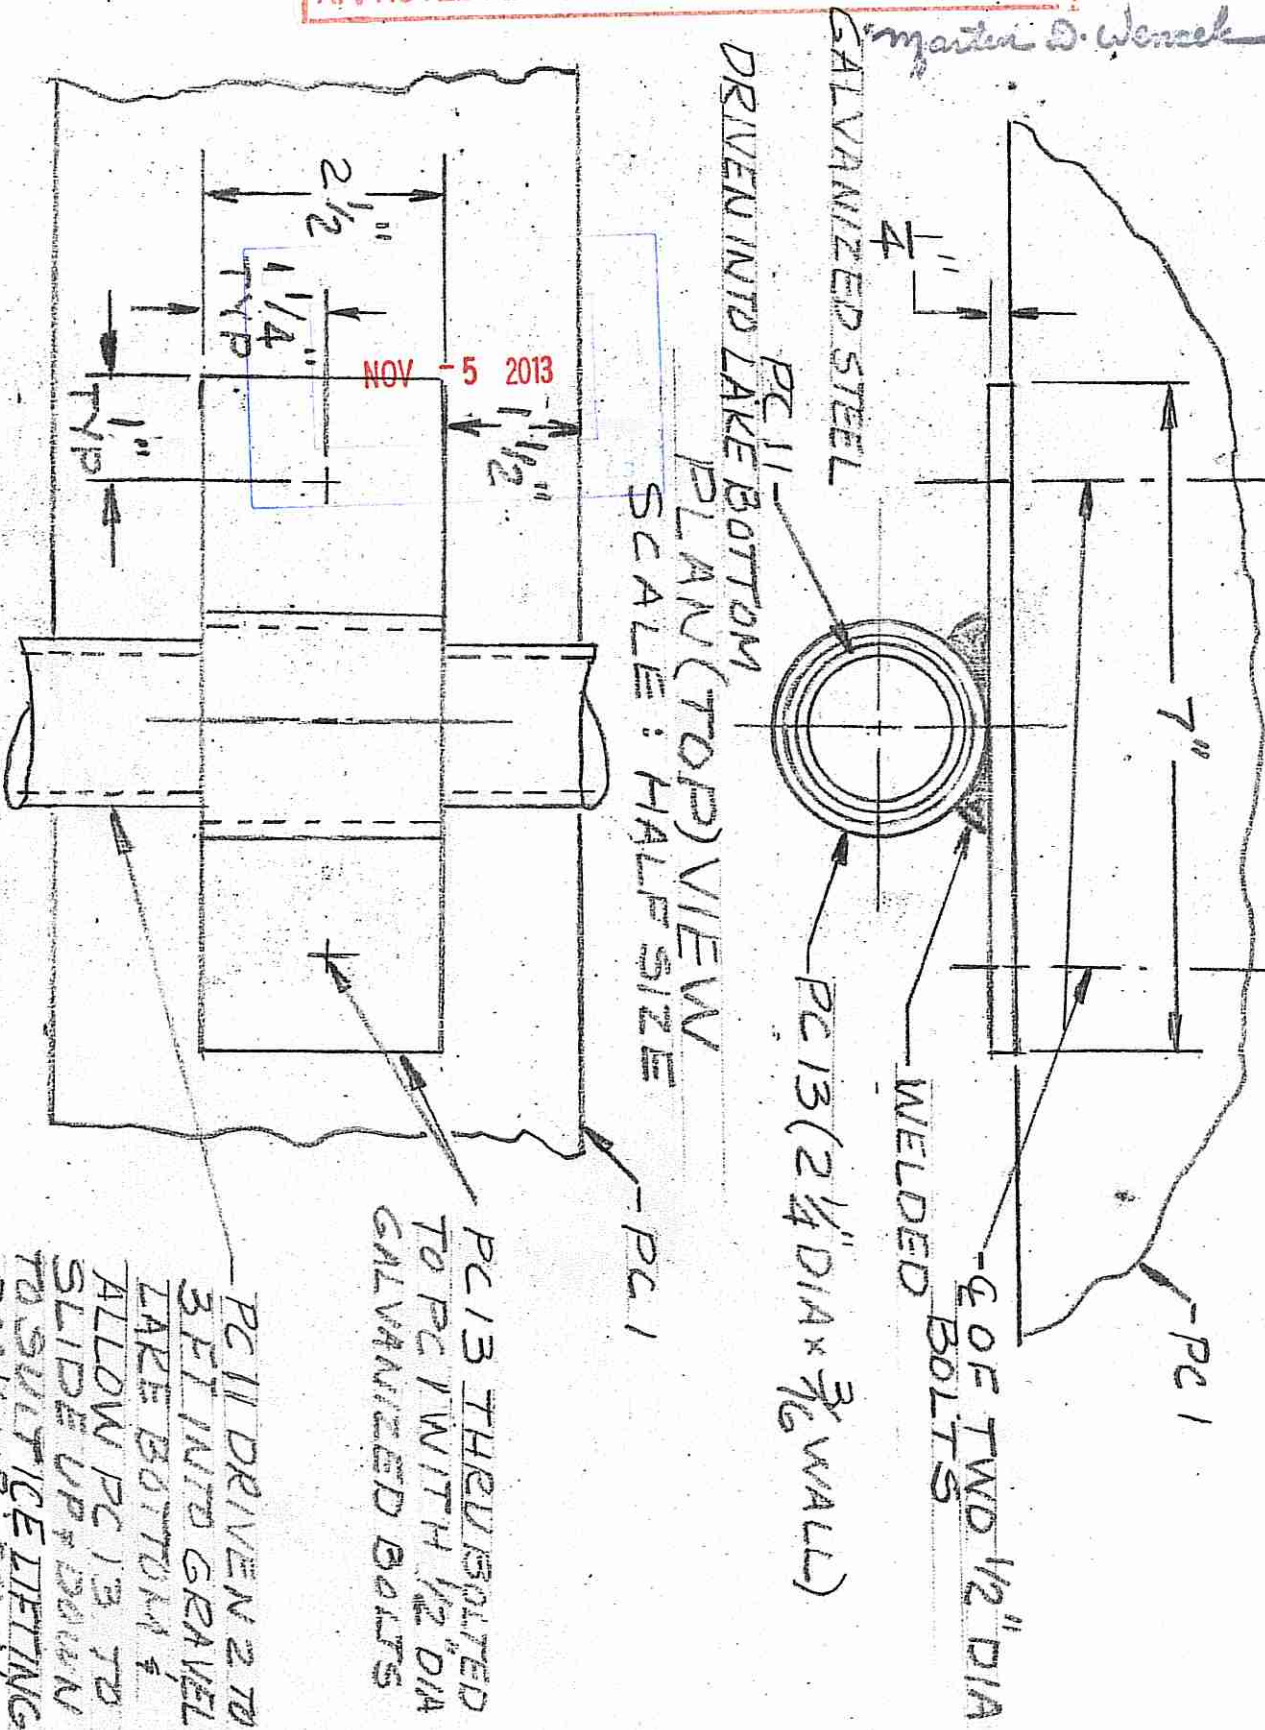

PLAN (TOP) VIEW  
 SCALE: HALF SIZE

DETAIL OF PC 13  
 QUANTITY OF 2

PC 13 THRU BOLTED TO PC 1 WITH 1/2 DIA GALVANIZED BOLTS

PC 11 DRIVEN 2 TO 3 FT INTO GRAVEL LAKE BOTTOM & ALLOW PC 13 TO SLIDE UP & DOWN TO SUITICE LIFTING DOCK UP & DOWN

PROPOSED DOCK - ACCESS Docks & PLAT 83/BL10/LOTS SHEET 3 OF 3  
 PREPARED BY RICH SICILIANO SCALE 1/4" = 1'-0"